

OFFICE OF THE MARION COUNTY SURVEYOR

SECTION RECORD CORNER

SECTION 19 TOWNSHIP 17 RANGE 5

DATE: 5-2-02

PARTY CHIEF: Wilcoxen

CREW: _____

TYPE OF MARKER: Harrison down 2"


METHOD OF ESTABLISHMENT: County: 4-19-96

IN. S.P.C. E ZONE NAD '83

NAME: 17051904

N: 517058.0590(m)

E: 70322.4710(m)

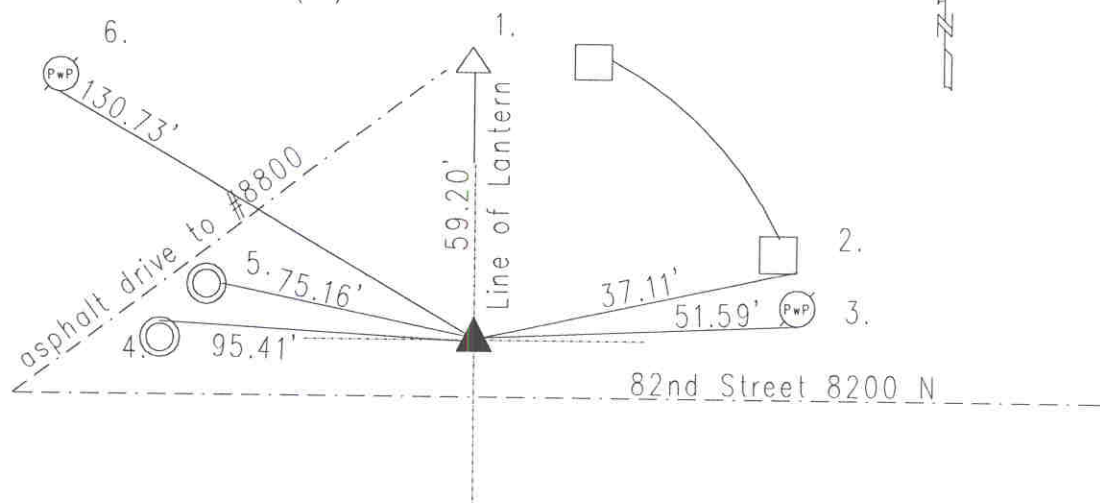

Corner was not set in original 1821 survey. Appeared 1st per Lawrence Township Legal Survey Book pg. 4. Mayhew 4-1853 did legal, portioning parts of 4 sections. WQ 19-17-5 plat but no mention of type of marker. Distances divided per Q corners. Stone then set. No falling given to EQ 24-17-4, although, said E marked in pencil on plat as stone. Legal 8-1854 Wilson per Law. Town. Legal Survey Book pg. 9 called stone. Two witness trees taken; 8" ironwood N 20 1/2 W 21 links; 8" buckeye N 38 1/2 E 14 links. Falling of 71 links pencilled on plat. 11-12-69 SeFranka tied E Q 24-17-4 and called WQ iron pin. Falling 59.18' (89.67 links) S from EQ of 24-17-4. Ties to WQ on tie card. 5-11-76 Wilcoxen called WQ iron pin. Falling 59.20' given to EQ 24-17-4. 9-20-79 Wilcoxen called iron pin w/falling 59.20'. Excavated 7-8-82 Cleveland. 2'x2' hole dug 3" dn. 30" iron rod fd. No stone. 17051904

| REF. | DISTANCE | DESCRIPTION |
|------|----------|---|
| 1. | 59.20' | Due N to EQ 24-17-4 (Mag nail) |
| 2. | 37.11' | East most top corner of concrete column |
| 3. | 51.59' | Boat spike S guy pole #98-251 A 10"up |
| 4. | 95.41' | Cut 'x' N-rim of storm manhole |
| 5. | 75.16' | Cut 'x' E rim of sewer manhole |
| 6. | 130.73' | PK nail S PwP#60-221 B 12"up |
| | | |
| | | |
| | | |
| | | |